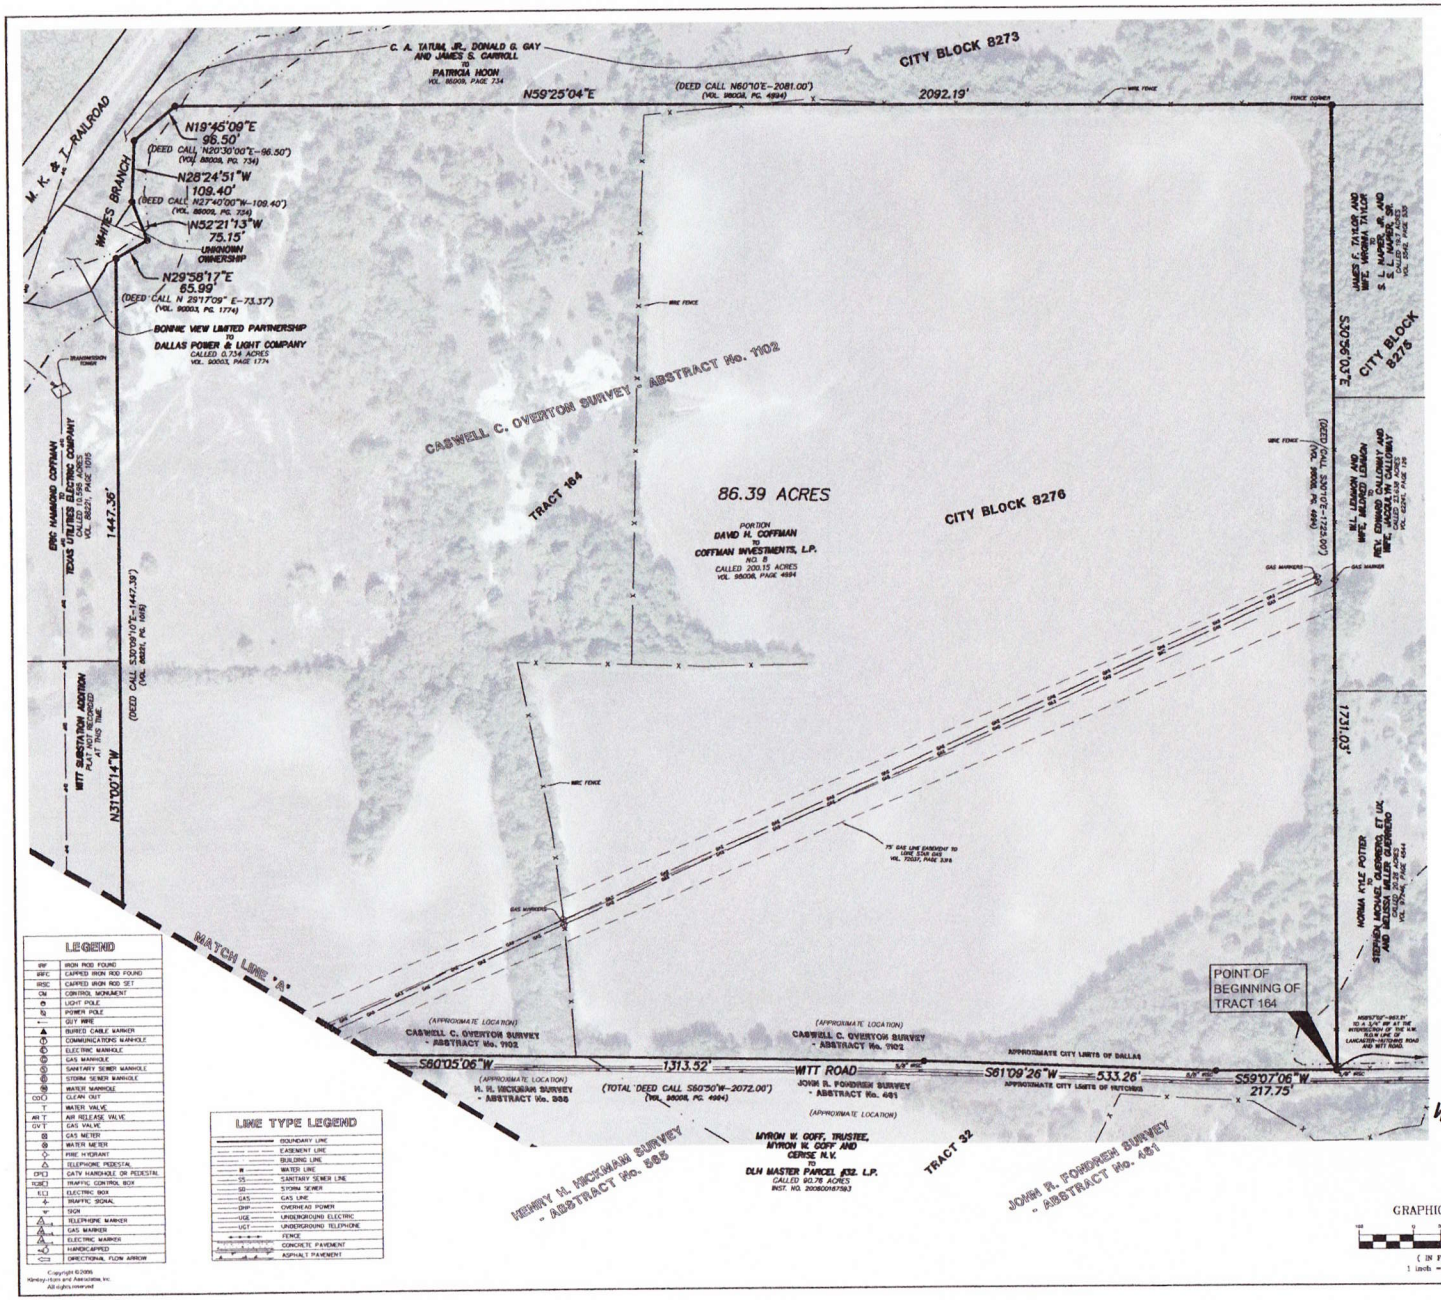

METES AND BOUNDS

Tract 164
86.39 Acres
Caswell C. Overton Survey, Abstract No. 1102
City of Dallas, Dallas County, Texas

BEING a tract of land situated in the Caswell C. Overton Survey, Abstract Number 1102, Block 8276 of the City of Dallas, Dallas County, Texas, and being a portion of a called 200.15 acre tract of land (No. 8) described in a Special Warranty Deed from David H. Coffman to Coffman Investments, L.P., recorded in Volume 96008, Page 4994 of the Deed Records of Dallas County, Texas (hereinafter referred to as DRDCT), with the herein described tract of land being further described as field on the ground by metes and bounds as follows:

BEGINNING at a 5/8-inch iron rod with "KHA" cap set (herein after referred to as 5/8-inch iron rod set) in the north line of Witt Road for the southeast common corner of said called 200.15 acre tract and a called 25.26 acre tract described in a Warranty Deed from Norma Kyle Potter to Stephen Michael Guerrero, et ux, and Melissa Miller Guerrero, recorded in Volume 97345, Page 4844 - DRDCT, from which said point, a 3/4-inch iron rod found for the southeast corner of said Guerrero tract in the north line of Witt road and the west line of Lancaster-Hutchins Road bears North 58°57'02" East, a distance of 857.21 feet;

THENCE along the north line of Witt Road the following courses and distances:

South 59°07'06" West, a distance of **217.75 feet** to a 5/8-inch iron rod set for corner;

South 61°09'26" West, a distance of **533.26 feet** to a 5/8-inch iron rod set for corner;

South 60°05'06" West, a distance of **1313.52 feet** to a 5/8-inch iron rod set for corner;

THENCE South 05°51'44" West, departing the north line of Witt road, a distance of **25.38 feet** to a 5/8-inch iron rod found for the northwest corner of a called 90.78 acre tract (Tract 32) of land described in a Special Warranty Deed from Myron W. Goff, Trustee, Myron W. Goff and Cerise N.V. to DLH Master Parcel #32 L.P., recorded in Instrument Number 20080018793 of the Official Public Records of Dallas County Texas;

THENCE South 35°26'25" West, along the centerline of Witt Road, a distance of **123.84 feet** to a PK Nail found for the east corner of a called 10.595 acre tract described in a Warranty Deed from Eric Hammond Coffman to Texas Utilities Electric Company, recorded in Volume 88221, Page 1915 - DRDCT;

THENCE North 31°00'14" West, along the northeast line of said Texas Utilities Electric Company Tract, a distance of **1447.36 feet** to a point in the centerline of Whites Branch for the north corner of said tract and being in an east line of a called 0.734 acre tract described in a Special Warranty Deed from Bonnie View Limited Partnership to Dallas Power & Light Company, recorded in Volume 90003, Page 1774 - DRDCT;

THENCE North 29°58'17" East, along Whites Branch and an east line of said Dallas Power & Light Company tract, a distance of **85.99 feet** to a point for the north corner of said tract;

THENCE North 52°21'13" West, along the centerline of Whites Branch, a distance of **75.15 feet** to a point for a corner of a tract of land described in a Warranty Deed from C. A. Tatum, Jr., Donald G. Gay and James S. Carroll to Patricia Hoon, described in Volume 86008, Page 734 - DRDCT;

THENCE along Whites Branch and said Hoon tract, the following courses and distances:

North 28°24'51" West, a distance of **109.40 feet** to a point for corner;

North 19°45'09" East, a distance of **96.50 feet** to a point for corner;

THENCE North 59°25'04" East, departing said Branch, along the southeast line of said Hoon tract and generally with a fence for part of the way, a distance of **2092.19 feet** to a fence corner for the northwest corner of a called 19.7 acre tract described in a Warranty Deed from James F. Taylor and wife, Virginia Taylor to S.L. Napier, Jr. and B.L. Napier, Sr., recorded in Volume 5542, Page 105 - DRDCT;

THENCE South 30°56'00" East, along a fence and the southwest line of said Napier Tract, a called 23.638 acre tract described in a Warranty Deed from W.L. Lemmon and Mildred Lemmon to Rev. Edward Calloway and wife, Janquelyn Calloway, recorded in Volume 92141, Page 126 - DRDCT, and then aforementioned Guerrero tract, passing a fence post at a distance of **1731.03 feet** to the **POINT OF BEGINNING** and containing 86.39 acres, more or less.

Bearing system based upon the Texas Coordinate System of 1983 (Grid Azimuth)

TO: Allen Development of Texas, LLC, a Delaware limited liability company
DLH Master Parcel 8 161-164, L.P., a Delaware limited partnership
DLH Master Parcel 8 161-164, GenPar, LLC, a Delaware limited liability company
Lawyers Title Insurance Company
Coffman Investments, L.P.
Diane Coffman Garvin
Stewart Title Guaranty Company

This is to certify that this map or plat and the survey on which it is based were made in accordance with "Minimum Standard Detail Requirements for ALTA/ACSM Land Title Surveys," jointly established and adopted by ALTA, ACSM and NSPS in 2005, and includes items 1,2,3,4,6, 13, and 16 of Table A thereof. Pursuant to the Accuracy Standards as adopted by ALTA, NSPS, and ACSM and in effect on the date of this certification, undersigned further certifies that the positional uncertainties resulting from the survey measurements made on the survey do not exceed the allowable Positional Tolerance.

Surveyed: June 2006
Preliminary Issue: June 29, 2006
Issued: July 28, 2006
Revised: August 30, 2006

STATE OF TEXAS REGISTERED MARK C. WILLIAMS 5481 PROFESSIONAL LAND SURVEYOR

Mark C. Williams
Registered Professional Land Surveyor #5481
Kimley-Horn and Associates, Inc.
12700 Park Central Drive, Dallas, Texas 75251
(972) 770-1300

LEGEND

IRF	IRON ROD FOUND
IRFC	CAPPED IRON ROD FOUND
IRSC	CAPPED IRON ROD SET
CM	CONTROL MONUMENT
LP	LIGHT POLE
PP	POWER POLE
GW	GUY WIRE
BCM	BURIED CABLE MARKER
CMH	COMMUNICATIONS MANHOLE
EMH	ELECTRIC MANHOLE
GMH	GAS MANHOLE
SMH	SANITARY SEWER MANHOLE
STMH	STORM SEWER MANHOLE
WMH	WATER MANHOLE
COC	CLEAN OUT
WV	WATER VALVE
AR	AIR RELEASE VALVE
GV	GAS VALVE
GM	GAS METER
WM	WATER METER
FH	FIRE HYDRANT
TP	TELEPHONE PEDESTAL
CPED	CATV HANDHOLE OR PEDESTAL
TCB	TRAFFIC CONTROL BOX
ELEC	ELECTRIC BOX
TS	TRAFFIC SIGNAL
SN	SIGN
TM	TELEPHONE MARKER
GM	GAS MARKER
EM	ELECTRIC MARKER
HC	HANDICAPPED
	DIRECTIONAL FLOW ARROW

LINE TYPE LEGEND

	BOUNDARY LINE
	EASEMENT LINE
	BUILDING LINE
W	WATER LINE
SS	SANITARY SEWER LINE
SD	STORM SEWER
GAS	GAS LINE
OHP	OVERHEAD POWER
UGE	UNDERGROUND ELECTRIC
UCT	UNDERGROUND TELEPHONE
	FENCE
	CONCRETE PAVEMENT
	ASPHALT PAVEMENT

Copyright ©2006
Kimley-Horn and Associates, Inc.
All rights reserved

Kimley-Horn and Associates, Inc.
12700 Park Central Drive, Suite 1800
Dallas, Texas 75251
Tel. No. (972) 770-1300
Fax No. (972) 239-3820

86.39 ACRES

HENRY M. HICKMAN SURVEY, ABSTRACT NO. 565,
CASWELL C. OVERTON SURVEY, ABSTRACT NO. 1102
CITY OF DALLAS AND CITY OF HUTCHINS
DALLAS COUNTY, TEXAS

ALTA/ACSM LAND TITLE SURVEY

TRACTS 161-164

Date: 06-28-06
Drawn by: PJG
Designed by: KHA
Checked by: CM
Approved by: MCW
Project No. 64011017

SHEET 2 OF 2

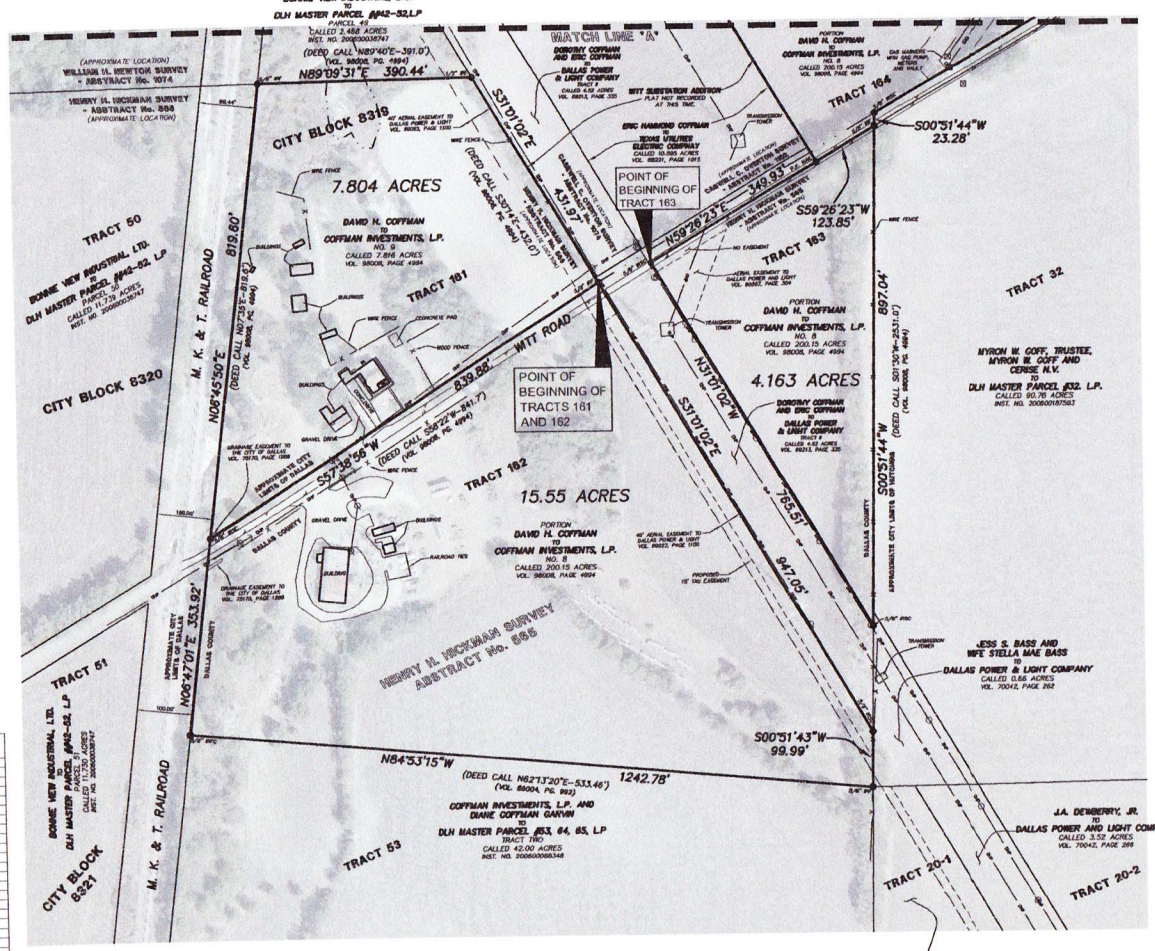
BONNIE VIEW INDUSTRIAL, LTD.
TO
DLH MASTER PARCEL #642-52,LP
CALLED 2.458 ACRES
INST. NO. 20060036747
(DEED CALL N89°40'E-391.0')
(VOL. 96004, PG. 4994)
N89°09'31"E 390.44'
(APPROXIMATE LOCATION)
WILLIAM H. NEWTON SURVEY
- ABSTRACT No. 1014
HENRY H. HICKMAN SURVEY
- ABSTRACT No. 565
(APPROXIMATE LOCATION)
CITY BLOCK 8319
CITY BLOCK 8320
CITY BLOCK 8321
TRACT 50
TRACT 51
TRACT 53
TRACT 161
TRACT 162
TRACT 163
TRACT 164
TRACT 32
TRACT 20-1
TRACT 20-2
7.804 ACRES
DAVID H. COFFMAN
TO
COFFMAN INVESTMENTS, L.P.
NO. 9
CALLED 7.816 ACRES
VOL. 98008, PAGE 4994
4.163 ACRES
PORTION
DAVID H. COFFMAN
TO
COFFMAN INVESTMENTS, L.P.
NO. 8
CALLED 200.15 ACRES
VOL. 98008, PAGE 4994
15.55 ACRES
PORTION
DAVID H. COFFMAN
TO
COFFMAN INVESTMENTS, L.P.
NO. 8
CALLED 200.15 ACRES
VOL. 98008, PAGE 4994
POINT OF BEGINNING OF TRACTS 161 AND 162
POINT OF BEGINNING OF TRACT 163
MATCH LINE "A"
DOROTHY COFFMAN AND ERIC COFFMAN
TO
DALLAS POWER & LIGHT COMPANY
TRACT 9
CALLED 4.82 ACRES
VOL. 89213, PAGE 335
MITT SUBSTATION ADDITION
PLAT NOT RECORDED
AT THIS TIME
ERIC HAMMOND COFFMAN
TO
TEXAS UTILITIES
ELECTRIC COMPANY
CALLED 10.595 ACRES
VOL. 89221, PAGE 1015
DAVID H. COFFMAN
TO
COFFMAN INVESTMENTS, L.P.
NO. 6
CALLED 200.15 ACRES
VOL. 98008, PAGE 4994
MYRON W. GOFF, TRUSTEE, MYRON W. GOFF AND CERISE N.V.
TO
DLH MASTER PARCEL #32, L.P.
CALLED 90.76 ACRES
INST. NO. 20080187583
JESS S. BASS AND WFE STELLA MAE BASS
TO
DALLAS POWER & LIGHT COMPANY
CALLED 0.66 ACRES
VOL. 70042, PAGE 262
J.A. DEWBERRY, JR.
TO
DALLAS POWER AND LIGHT COMPANY
CALLED 3.52 ACRES
VOL. 70042, PAGE 266
DALLAS COUNTY DEVELOPMENT TRACT NO. 5
TO
DLH MASTER PARCEL #30, L.P.
TRACT 1 (#20-1)
CALLED 14.37 ACRES
INST. NO. 20060054968
COFFMAN INVESTMENTS, L.P. AND DIANE COFFMAN GARVIN
TO
DLH MASTER PARCEL #53, 64, 65, L.P
TRACT TWO
CALLED 42.00 ACRES
INST. NO. 20060038348
BONNIE VIEW INDUSTRIAL, LTD.
TO
DLH MASTER PARCEL #42-52, L.P
PARCEL 49
CALLED 7.816 ACRES
INST. NO. 20060036747
BONNIE VIEW INDUSTRIAL, LTD.
TO
DLH MASTER PARCEL #42-52, L.P
PARCEL 36
CALLED 1.739 ACRES
INST. NO. 20060036747
M. K. & T. RAILROAD
WITT ROAD
HENRY H. HICKMAN SURVEY
ABSTRACT No. 565
DALLAS COUNTY
S57°35'56"W 839.88'
(DEED CALL S58°22'W-841.7')
N08°45'50"E 819.60'
(DEED CALL N07°35'E-818.6')
(VOL. 96004, PG. 4994)
S31°01'02"E 431.97'
(DEED CALL S30°14'-432.0')
N59°26'23"E 349.93'
S59°26'23"W 123.85'
S00°51'44"W 23.28'
S00°51'44"W 897.04'
(DEED CALL S01°30'W-897.0')
(VOL. 96004, PG. 4994)
N31°01'02"W 431.97'
S31°01'02"E 765.51'
947.05'
S00°51'43"W 99.99'
N84°53'15"W 1242.78'
(DEED CALL N82°13'20"E-533.46')
(VOL. 96004, PG. 4922)
N06°47'01"E 353.92'
APPROXIMATE CITY LIMITS BOUNDARY CITY OF DALLAS
APPROXIMATE CITY LIMITS BOUNDARY CITY OF DALLAS
DALLAS COUNTY
DALLAS COUNTY
GRAVEL DRIVE
BUILDING
WIRE FENCE
WOOD FENCE
CONCRETE PAD
RAILROAD TIES
TRANSMISSION TOWER
GAS MARKER
GAS VALVE
WATER VALVE
5/8" IRF
5/8" IRC
5/8" IRS
1/2" IRC
1/2" IRF
1/2" IRS
100.00'
50.00'
80.44'
PROPOSED 15' ENCUMBRANCE
40' AERIAL EASEMENT TO DALLAS POWER & LIGHT VOL. 89213, PAGE 1100
AERIAL EASEMENT TO DALLAS POWER & LIGHT VOL. 89221, PAGE 994
GRADE EASEMENT TO THE CITY OF DALLAS VOL. 70170, PAGE 1269
GRADE EASEMENT TO THE CITY OF DALLAS VOL. 70170, PAGE 1269
